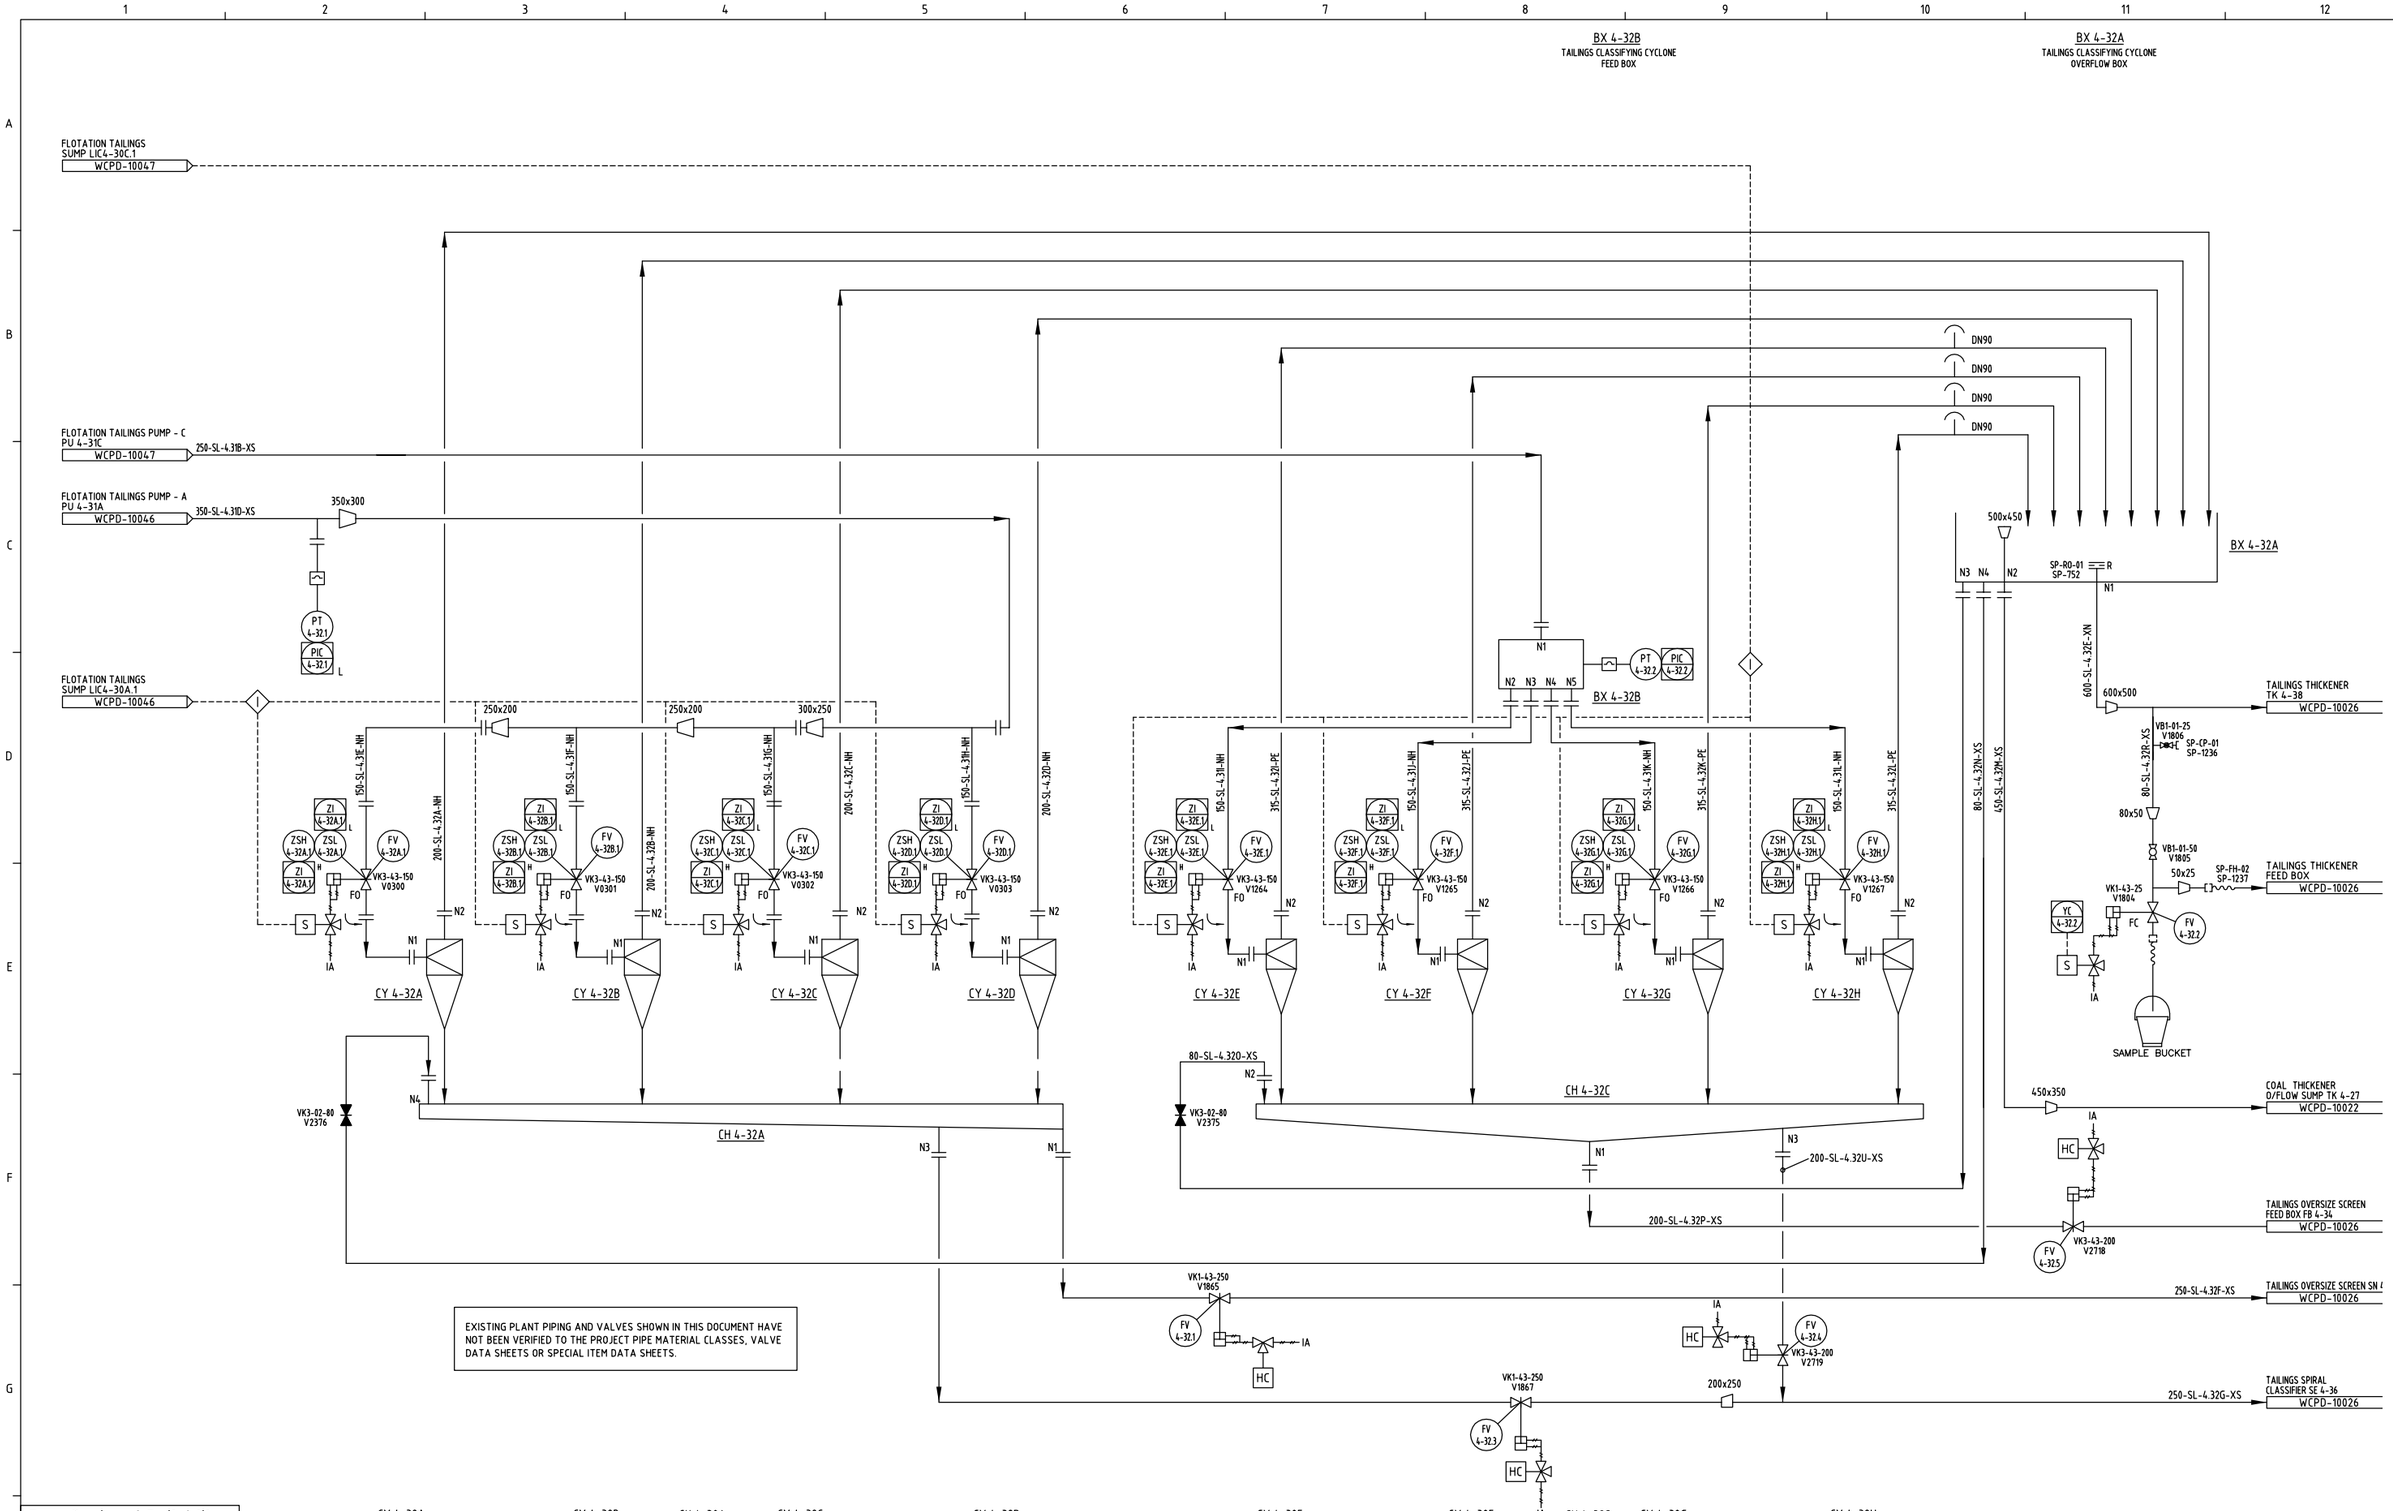

Valid until: 11:55am 29/09/2016

Printed by: SOUTH32\osboi

Raw Coal and Reliability Improvement Project

CY 4-32A TAILINGS CYCLONE - A | CY 4-32B TAILINGS CYCLONE - B | CH 4-32A TAILINGS CYCLONE UNDERFLOW DESCHARGE CHUTE - A | CY 4-32C TAILINGS CYCLONE - C | CY 4-32D TAILINGS CYCLONE - D | CY 4-32E TAILINGS CYCLONE - E | CY 4-32F TAILINGS CYCLONE - F | CH 4-32C OVERSIZE CHUTE - C | CY 4-32G TAILINGS CYCLONE - G | CY 4-32H TAILINGS CYCLONE - H

NOTE: THIS DRAWING WAS PREVOUSLY H330700-0600-05-03

	DATE	PROJECT/WBS No	CHANGE APPROVAL No	DRAWING STATUS	DRAWN	CHECKED	DISC. ENGINEER OR SPECIALIST	RESP ENG	REGN APPR
5	08/03/12	-	-	AS BUILT	M BATES	R CLULOW	-	P CRISAFULLI	-
4	28/11/11	-	-	RELOCATED FV4-32.1 FROM WCPD-10026 CHANGED VALVES FV4-32.1, FV4-32.3, FV4-32.4 & FV4-32.5 TO HAND CONTROL -	M BATES	R CLULOW	R CLULOW	-	-
3	11/05/2011	H333588	-	HOLD REMOVED VENTS ADDED LINES MODIFIED VALVE FAILURE POSITIONS ADDED	L. MILLS	D. WRIGHT	M. DREESSEN	S.NEWLAND	-
2	06/12/2010	H333588	-	FLANGES ADDED TO EXISTING CYCLONE INLETS HOLD ADDED NOTES MODIFIED -	L. MILLS	J. HOWES	M. DREESSEN	D. PAXTON	-

DRAWING REVISIONS

FUNCTIONAL LOCATION CODES

INDEX CODES

REFERENCE DRAWINGS

bhpbilliton

Illawarra Services Pty Ltd
Westcliff Coal Preparation Plant
Wedderburn Road
Appin, New South Wales 2560
bhpbilliton.com

DRAWING PRODUCED BY: aurecon HATCH

RESPONSIBLE ENGINEER: S. NEWLAND
SUPERVISOR: D. BRIDGE
ORDER No:
CONTRACTOR/SUPPLIER REF No: H333588-1300-05-031-0019
CONTRACTOR DETAILS

This design is the property of BHPBilliton Illawarra Coal Holdings Pty Ltd. ABN 69 093 857 286

B1

WEST CLIFF COAL PREPARATION PLANT
RAW COAL RELIABILITY IMPROVEMENT PROJECT
TAILINGS THICKENING AND DISPOSAL SHEET 2 OF 2
PIPING & INSTRUMENTATION DIAGRAM

CHANGE APPROVAL NUMBER:
PROJECT/WBS No: H-333588
DRAWN: L. MILLS
CHECKED: J. HOWES
DISC. ENGINEER OR SPECIALIST: M. ROSS
DISC. ENGINEER OR SPECIALIST: M. DREESSEN
RESPONSIBLE ENGINEER: D. PAXTON
REGISTRATION APPROVAL
AUTOCAD FILE NAME:
AUTOCAD PRINT:
DATE DRN: 10/12/2010
SCALE: NTS
DRAWING No: WCPD-10027
DRAWING STATUS: AS BUILT
REV No: 5

33A41502733

FULL SIZE 0 50 100 150 200 250 300